


PROPERTY CORNERS, SERVICE WALKS, CURB, OVERHEAD WIRES, NOT ENCROACHING, AREA AND DESCRIPTION ARE OMITTED BY CONTRACTUAL AGREEMENT. BUYER MAY ORDER PROPERTY MARKERS AT A COST OF \$60 PER CORNER WITHIN 90 DAYS OF THE DATE OF THIS SURVEY. SURVEY INFORMATION AND/OR TOPOGRAPHY DEPICTED ON THIS SURVEY SHALL NOT BE REFERENCED TO OR USED FOR ANY OTHER DESIGN PURPOSES WITHOUT THE WRITTEN CONSENT OF STEVEN R. KELLY, P.L.S. I RESERVE THE RIGHT TO REVISE THIS SURVEY UPON THE RECEIPT OF AN UPDATED TITLE REPORT. IF BUILDINGS ARE ON THIS PLAN, BUILDING OFFSET DISTANCES SHOWN ARE FOR THE PURPOSE OF CHECKING COMPLIANCE WITH ZONING AND DEED RESTRICTIONS ONLY. NO LIABILITY WILL BE ACCEPTED IF THESE DISTANCES ARE USED FOR ANY OTHER PURPOSE. THIS SURVEY IS BASED ON SURVEY CONTROL FOUND AT THE TIME OF THE SURVEY. THIS SURVEY IS A RETRACEMENT OF A DEED DESCRIPTION PROVIDED BY OUR CLIENT AND DOES NOT DENOTE OWNERSHIP. WE ARE NOT EXPERTS IN WETLANDS IDENTIFICATION, WETLANDS, IF ANY, HAVE NOT BEEN IDENTIFIED ON THIS PLAN.

RECEIVED

MAR 04 2020

COMMUNITY DEVELOPMENT

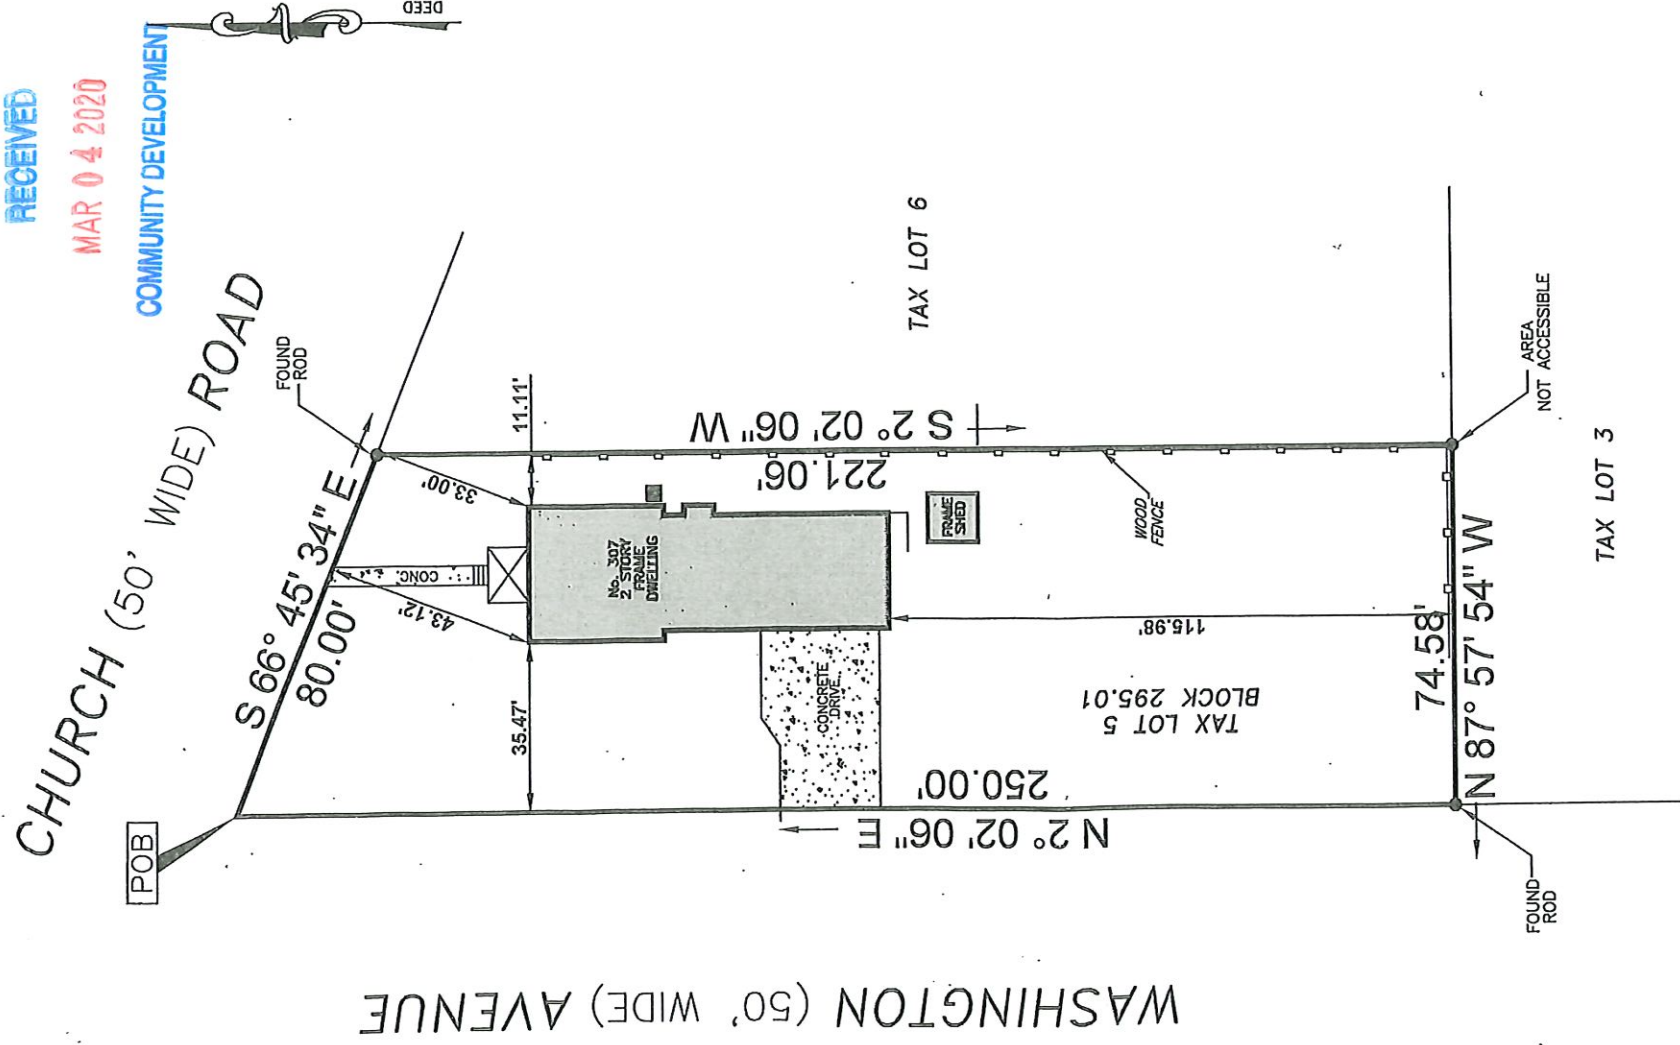

GROSS AREA = 17,565.34 S.F./0.40 ACRES

DESCRIPTION:

BEING LOT 5, BLOCK 295.01, ON THE TOWNSHIP OF CHERRY HILL TAX MAP.
BEING LOTS 1, 2, 3, 4, 5 AND 47 TO 51 INCLUSIVE, BLOCK 18, PLAN OF COLUMBIA LAKES VILLA.

THE UNDERSIGNED LICENSED SURVEYOR (L.S.) HEREBY DECLARES TO, AND SOLELY FOR THE BENEFIT OF,

RYAN OSINSKI
THAT THIS PLAN WAS PREPARED FROM A SURVEY MADE UPON THE PREMISES SHOWING, AS OF THE DATE OF THIS CERTIFICATE, THE LOCATION OF ALL BUILDINGS, EASEMENTS, OR SERVICES APPARENT FROM AN INSPECTION OF THE SURFACE OF THE PREMISES. THIS PLAN IS NOT TO BE REPRODUCED IN ANY MANNER, NOR MAY IT BE RELIED UPON BY ANYONE OTHER THAN THE ABOVE NAMED PERSON OR PERSONS FOR WHOSE BENEFIT IT HAS BEEN PREPARED AND EMBOSSED WITH AN IMPRESSION SEAL. COPIES OF THIS PLAN WITHOUT IMPRESSION SEAL AND SIGNATURE IN RED INK ARE FOR MERE CONVENIENCE OF REFERENCE ONLY.

02/03/20

LICENSED PROFESSIONAL LAND SURVEYOR No. 22714, LICENSED PROFESSIONAL PLANNER No. 1979

STEVEN R. KELLY, P.L.S., P.P.

COPYRIGHT © 1995, 1994 & 1995 by STEVEN R. KELLY, P.L.S. ALL RIGHTS RESERVED.

Kelly
SURVEY

STEVEN R. KELLY, PROFESSIONAL LAND SURVEYOR
PO BOX 24, MEDFORD, N.J. 08055-0024
PHONE (800) 433-0384

MAP SHOWING SURVEY SITUATE IN

TOWNSHIP OF CHERRY HILL
COUNTY OF CAMDEN, N.J.
307 WASHINGTON AVENUE

- NOTES: 1. NOT TO BE USED FOR CONSTRUCTION.
2. NOT TO BE USED WITH A SURVEY AFFIDAVIT.

DATE	SCALE	DRAWN	CHKD	RK	SK	JOB No.
01/23/20	1"=40'					20200015